


This is to certify that we, Ingram Engineering, Inc., have during the month of November, 1992, prepared this record drawing of sewers constructed between Manhole 1 and Manhole 2 as shown on this plat of the Grace United Church on Mexico Road, O'Fallon, Missouri.

Ingram Engineering, Inc.
6 Westbury Drive
St. Charles, Missouri

Kenneth E. Ingram R.L.S. 992
Registered Land Surveyor

STATE OF MISSOURI
KENNETH E. INGRAM
E-10234
REGISTERED PROFESSIONAL ENGINEER

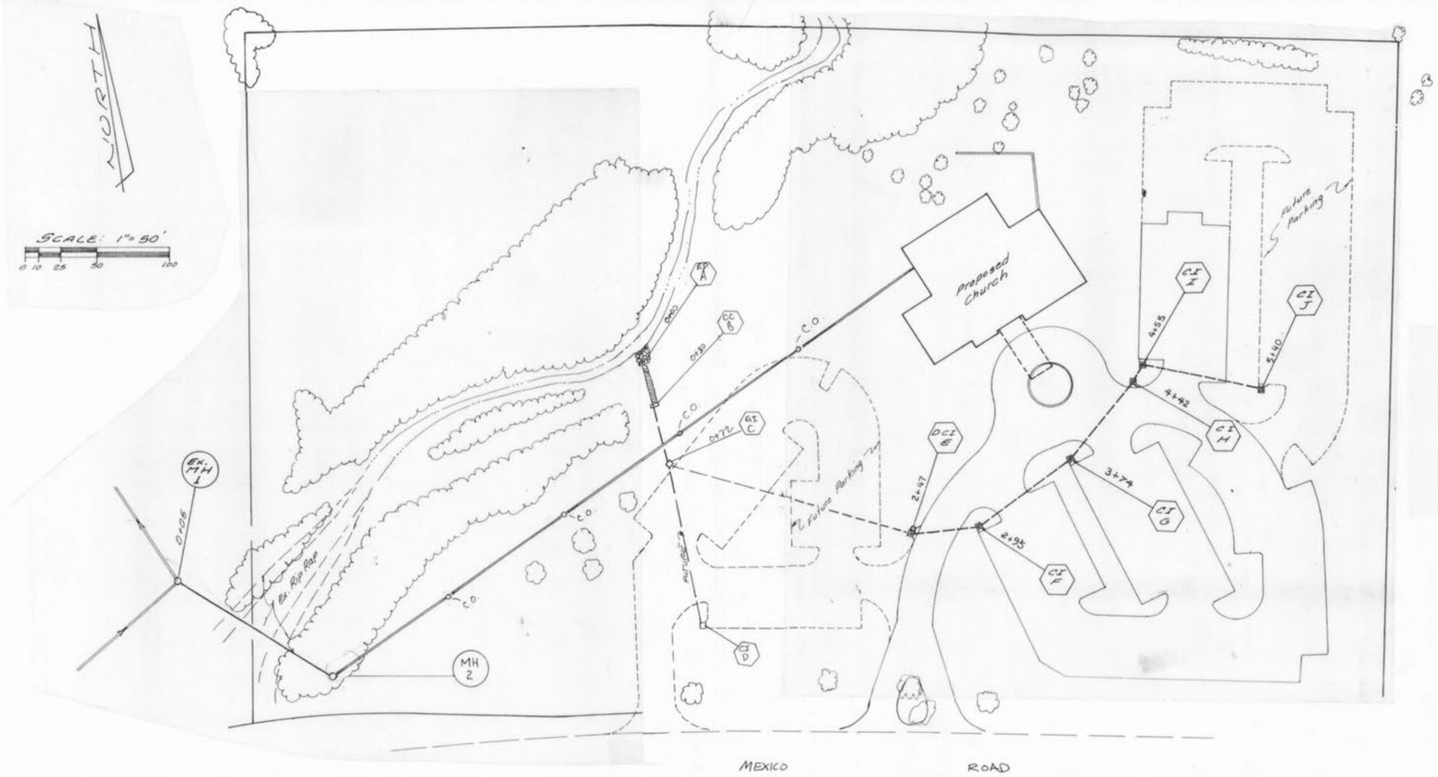


RECORD DRAWING

INGRAM ENGINEERING INC.
ENGINEERS - SURVEYORS - PLANNERS
6 WESTBURY DRIVE
ST. CHARLES, MISSOURI 63301
(314) 946-5566
FAX (314) 946-0713
IEI
KENNETH E. INGRAM, P.E.

REVISIONS

TITLE
GRACE UNITED CHURCH
MEXICO ROAD

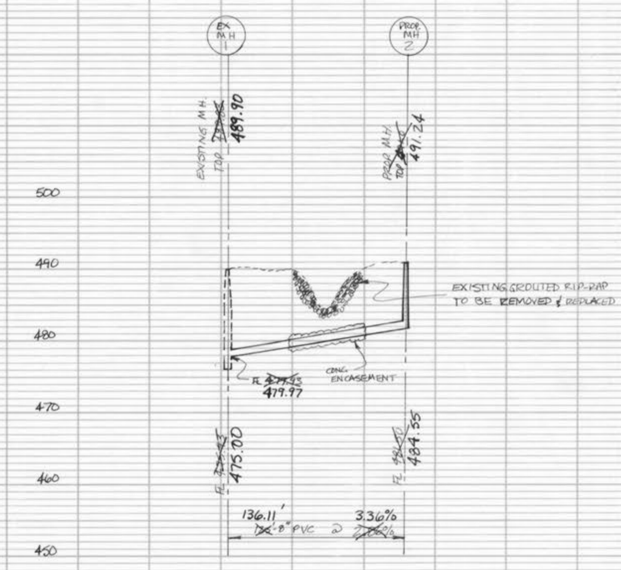DESIGNED J.Y.
DRAWN J.Y.
CHECKED K.I.
DATE 11/12/92
SEAL

SCALE 1/10 0 1 1/8

| JOB | SHEET | OF |
|---|---|---|
| 5459 | 1 | 1 |

Grace United Church
As-Built