




COPPERFIELD SUBDIVISION  
 PLAT 5  
 RB. 24, PG. 73

PROPERTY OF  
 DAVID E. & EULA B. QUELREUX  
 BK. 65, PG. 1436

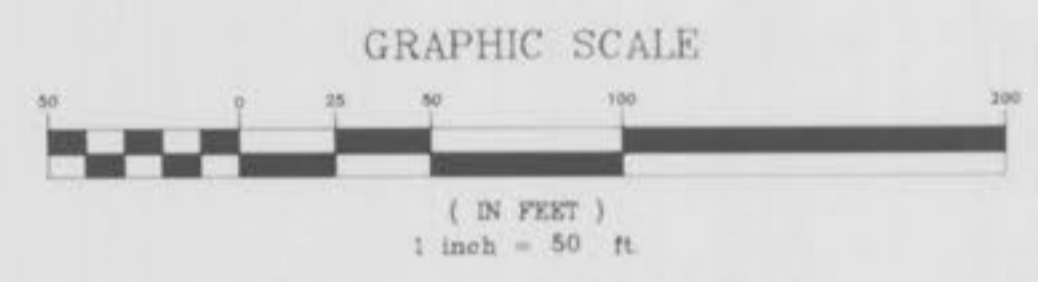


PROPERTY OF  
 BENARD & FLORENCE LOSFELER


AS-BUILTS ADDED JULY, 1992

FINAL SURVEY  
 SURVEYED  
 PLOTTED  
 NOTE BOOK  
 TEMPLATE  
 AREAS  
 NO. AREA CHECKED

ORIGINAL SURVEY  
 SURVEYED  
 PLOTTED  
 NOTE BOOK  
 TEMPLATE  
 AREAS  
 NO. AREA CHECKED

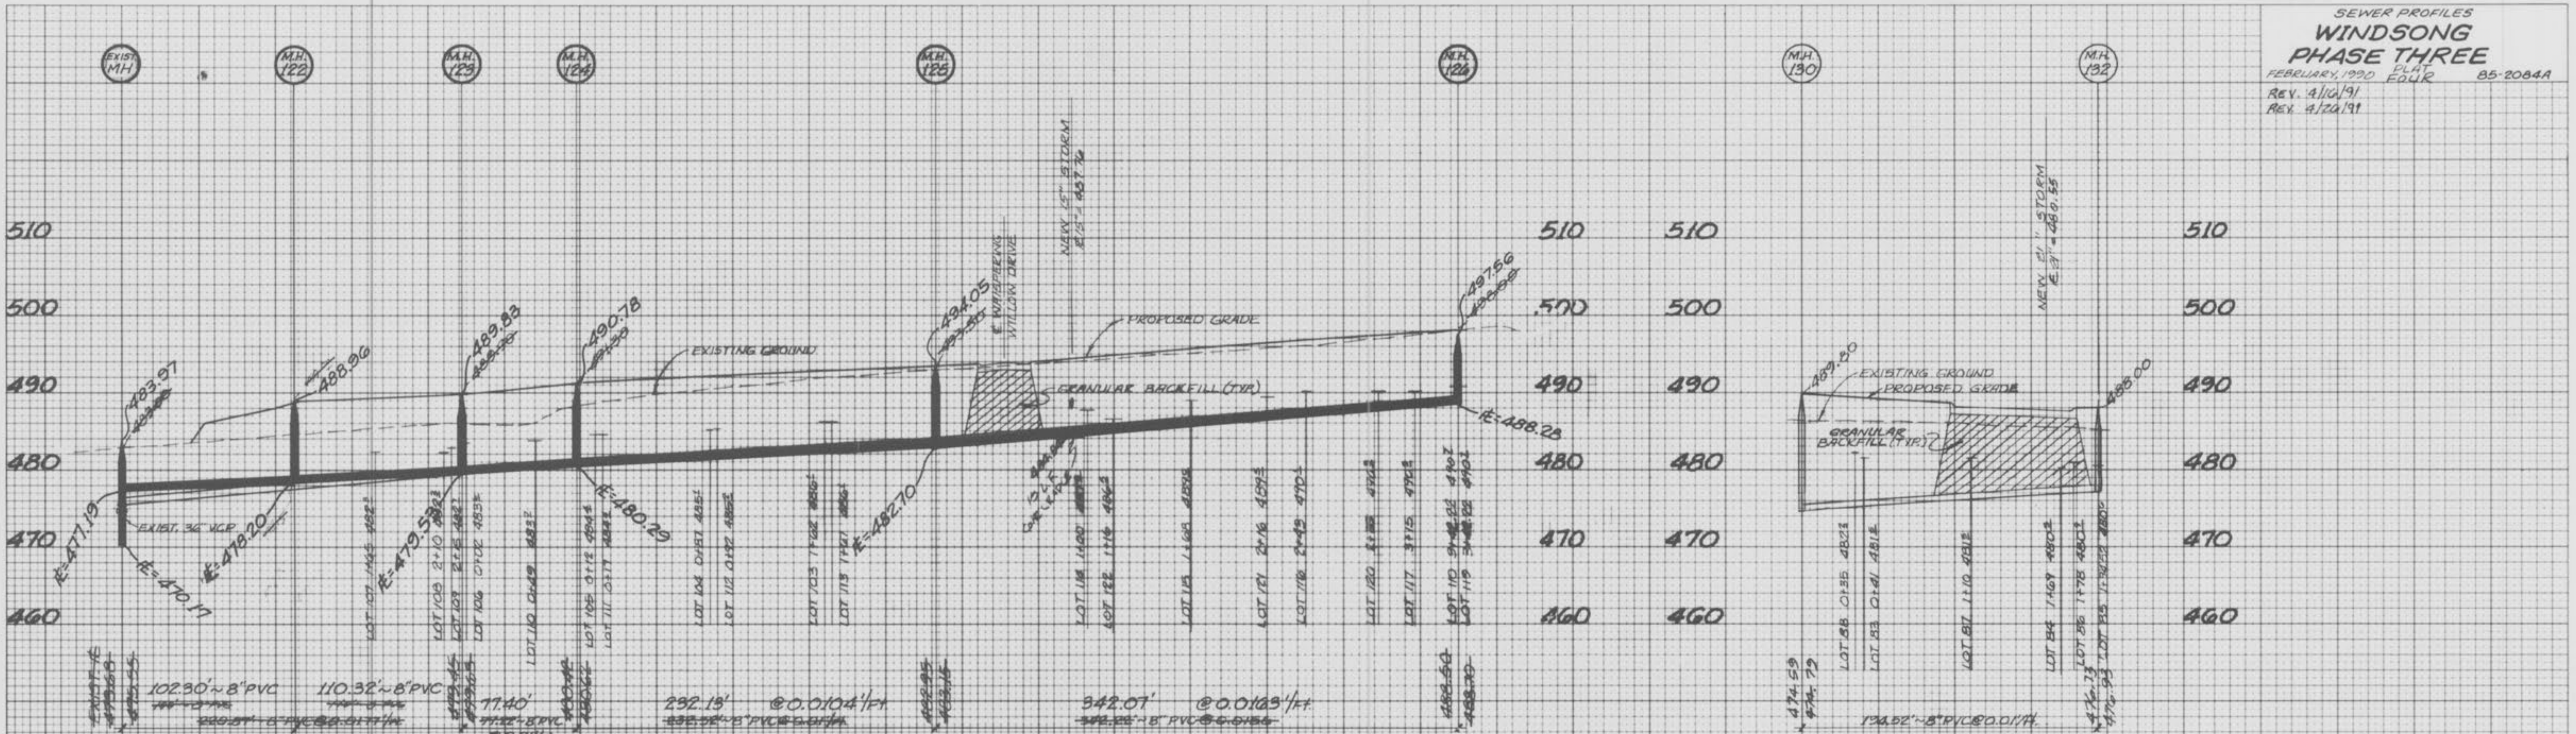

SCALE: 1" = 50' HORIZ.  
 1" = 10' VERT.

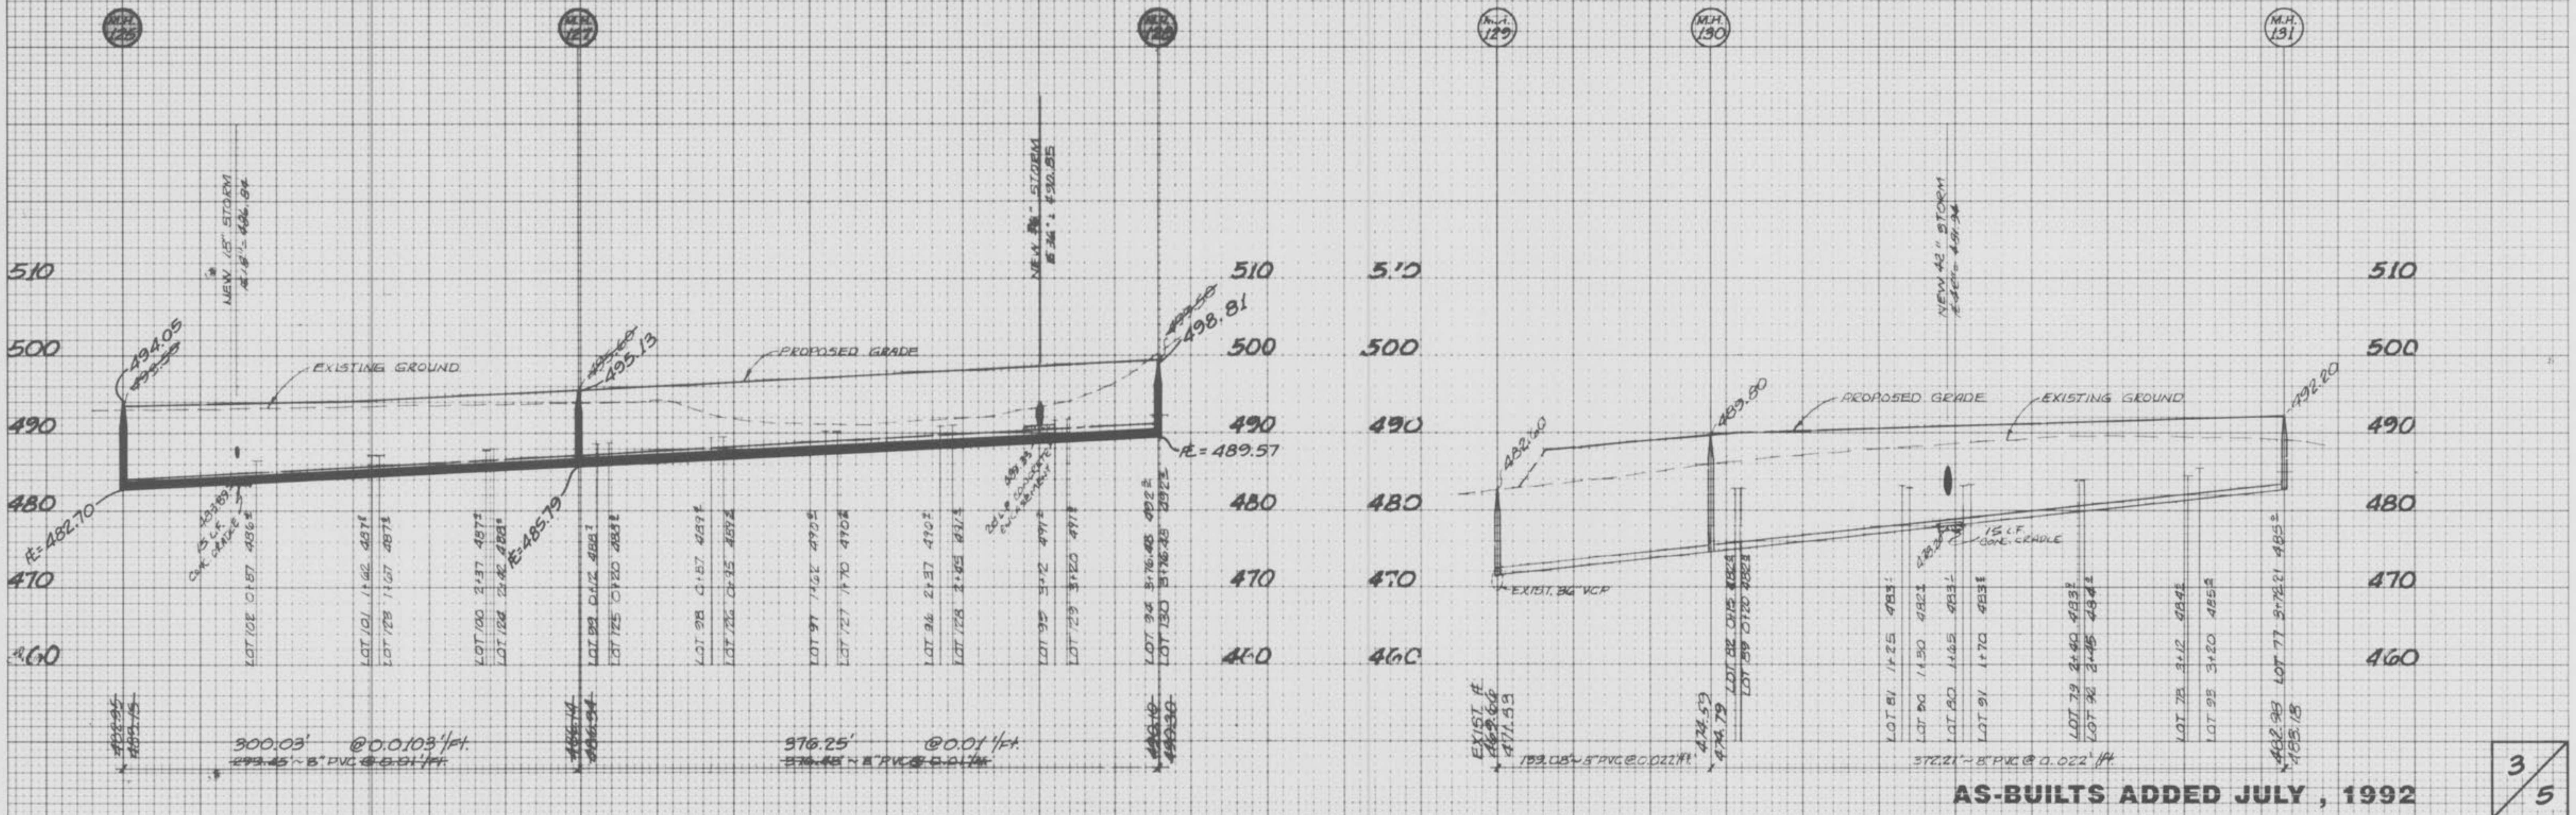

AS-BUILTS ADDED JULY, 1992



