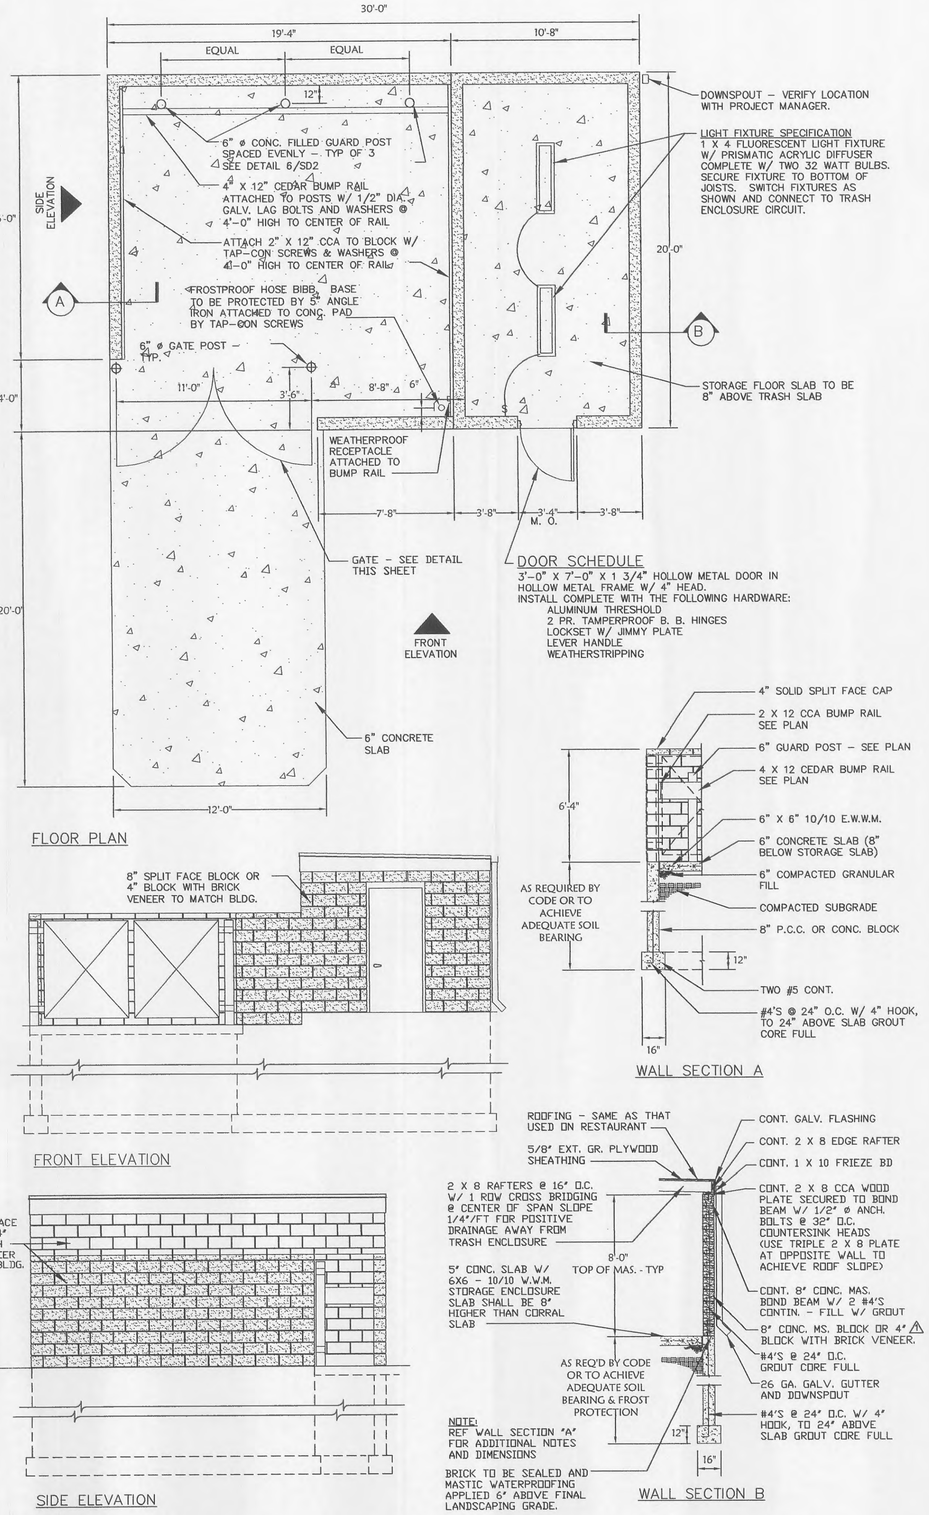

MASONRY TRASH CORRAL AND STORAGE ENCLOSURE
Not To Scale

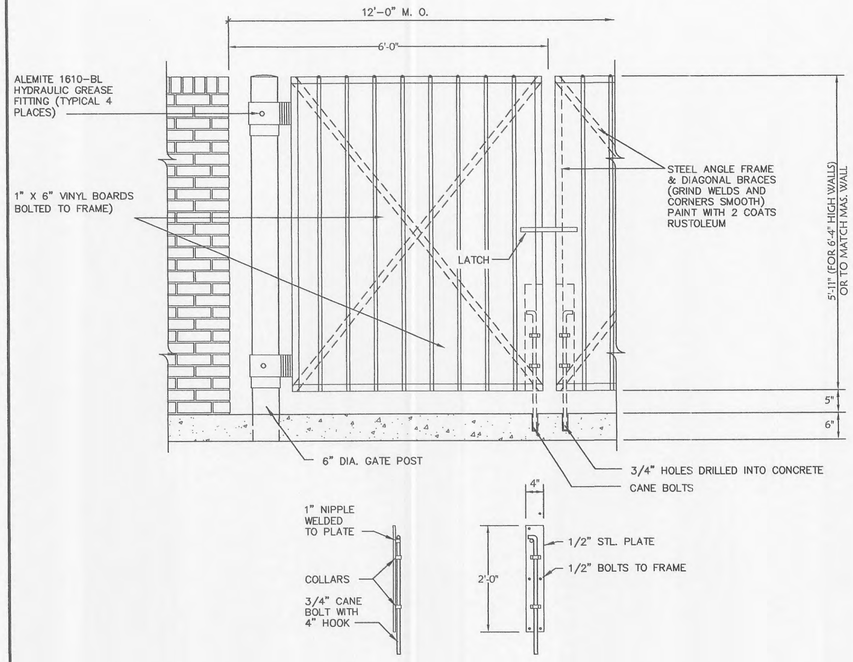

2 TRASH ENCLOSURE GATE & MOUNTING DETAILS
Not To Scale

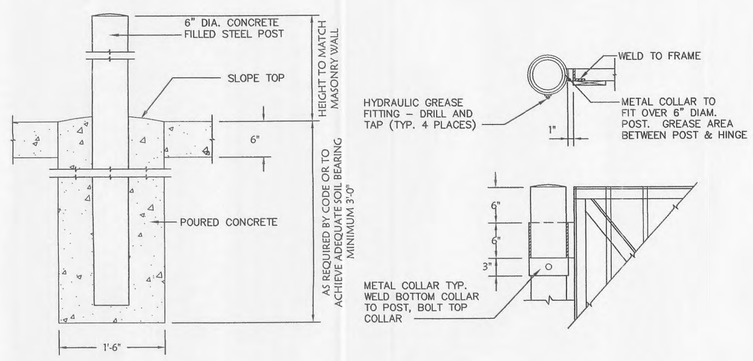

3 TRASH ENCLOSURE GATE POST
Not To Scale

DATE	REV	DESCRIPTION
12-18-06	1	REVISED SITE AND ADDED ROAD IMPROVEMENTS

Civil Engineering Inc.
Corp. Office: 1008 N.W. 1st St. Ste. "C" Bentonville, AR 72712 (479) 464.8850 (V) / (479) 464.9040 (F)
Regional Office: 11285 Strang Line Rd. Lenexa, KS 66215 (913) 310.0470 (V) / (913) 310.0261 (F)

McDonald's

THESE PLANS AND SPECIFICATIONS ARE THE PROPERTY OF McDONALD'S CORPORATION AND SHALL NOT BE REPRODUCED WITHOUT THEIR WRITTEN PERMISSION.

OFFICE ADDRESS: 10801 MASTIN BLVD. STE. 400, OVERLAND PARK, KS 66210
KANSAS CITY

STATUS	DATE	BY
PRELIMINARY	--/--/--	-
PLAN CHECKED	--/--/--	-
AS-BUILT	--/--/--	-
PROJECT NO.	06-0620	

SD5