SANITARY SEWER PROFILES
THE KNOLLS
NOV. 19, 1991 91-355

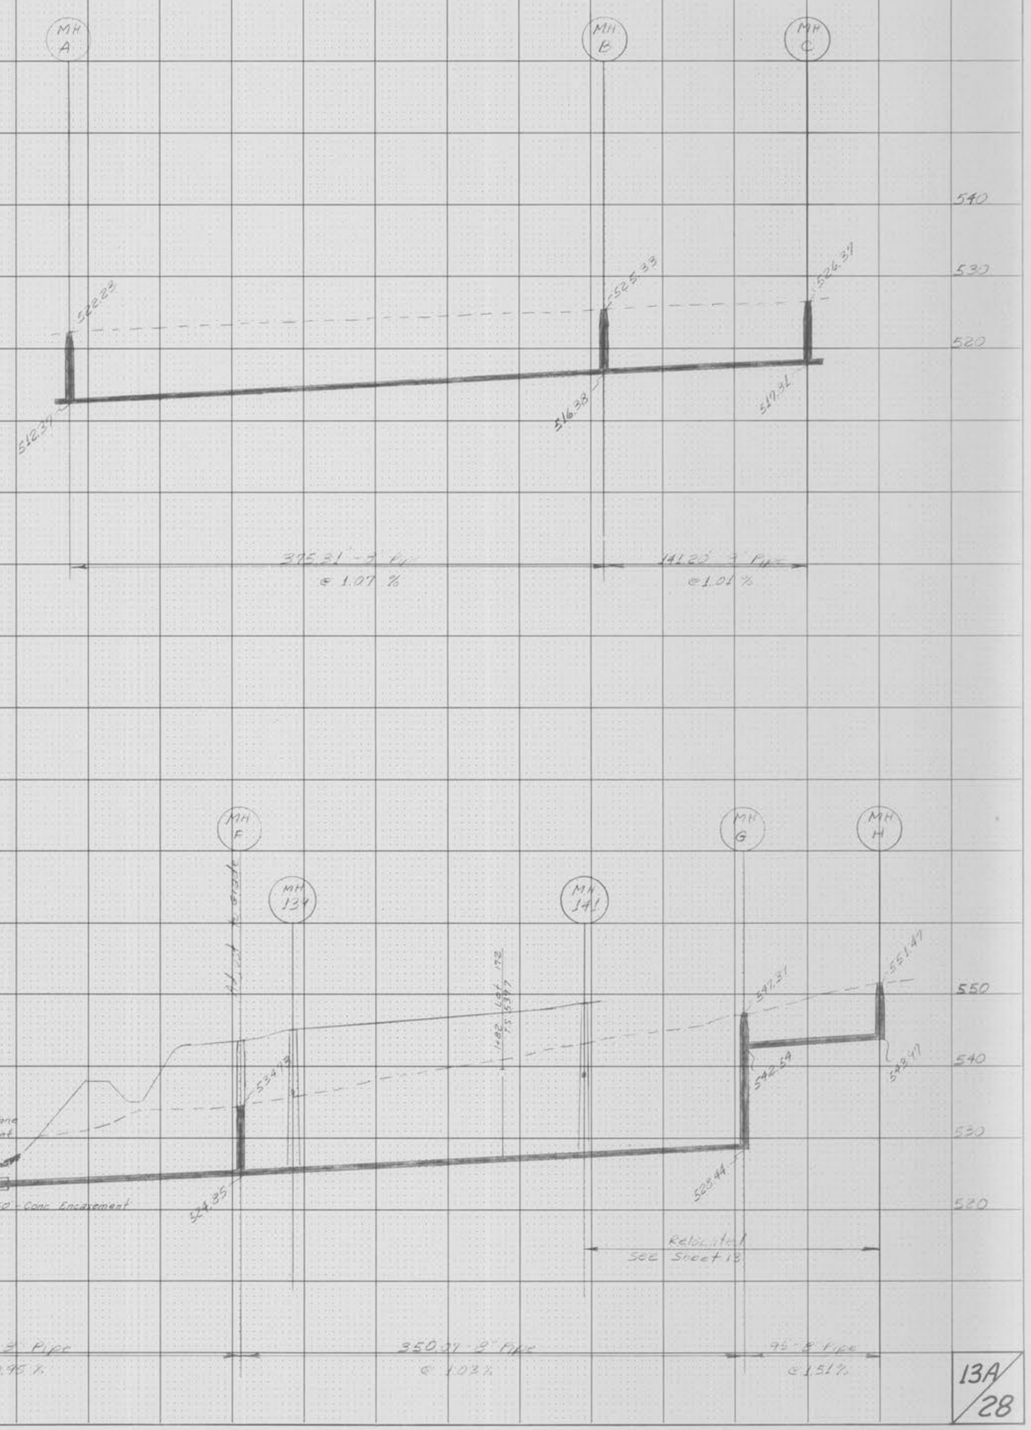

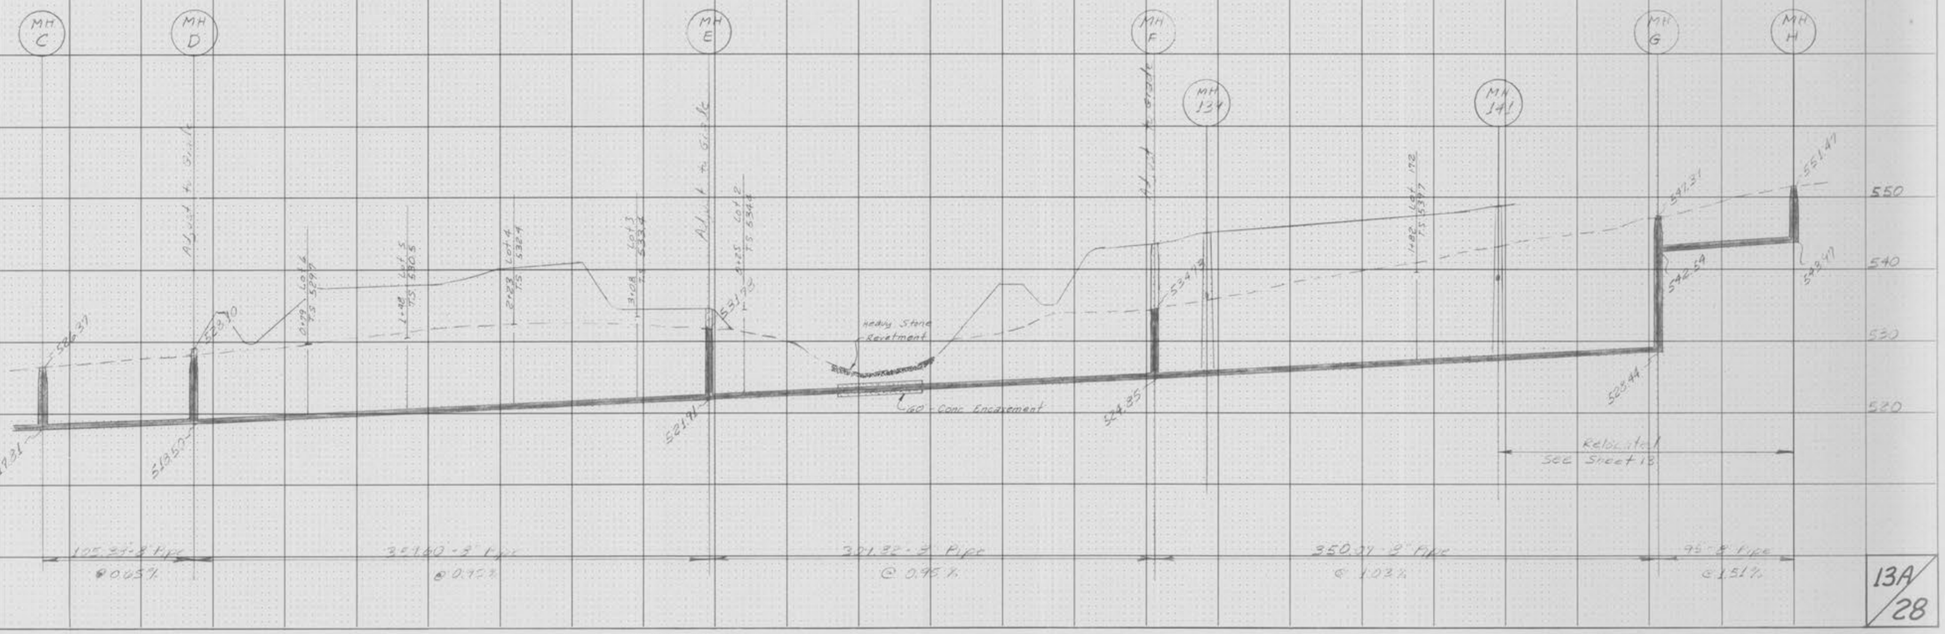

FINAL SURVEY — SURVEYED, PLOTTED, TEMPLATE AREAS, AREAS CHECKED, BY, DATE, NOTE BOOK, NO.

ORIGINAL SURVEY — SURVEYED, PLOTTED, TEMPLATE AREAS, AREAS CHECKED, BY, DATE, NOTE BOOK, NO.

13A/28

HIGHWAY FEDERAL AID SHEET
PLATE 3-FULL CROSS SECTION-LINE & DOT
TELEDYNE
PRINTED IN U.S.A.

AS-BUILT PLANS