



# SITE UTILITY PLAN - PHASE 3

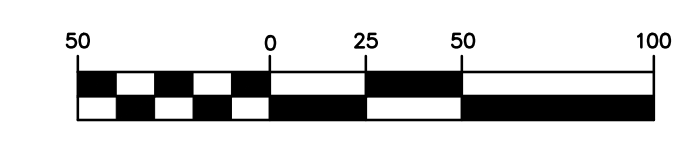

MAY, 2021

## LEGEND


EXISTING	PROPOSED

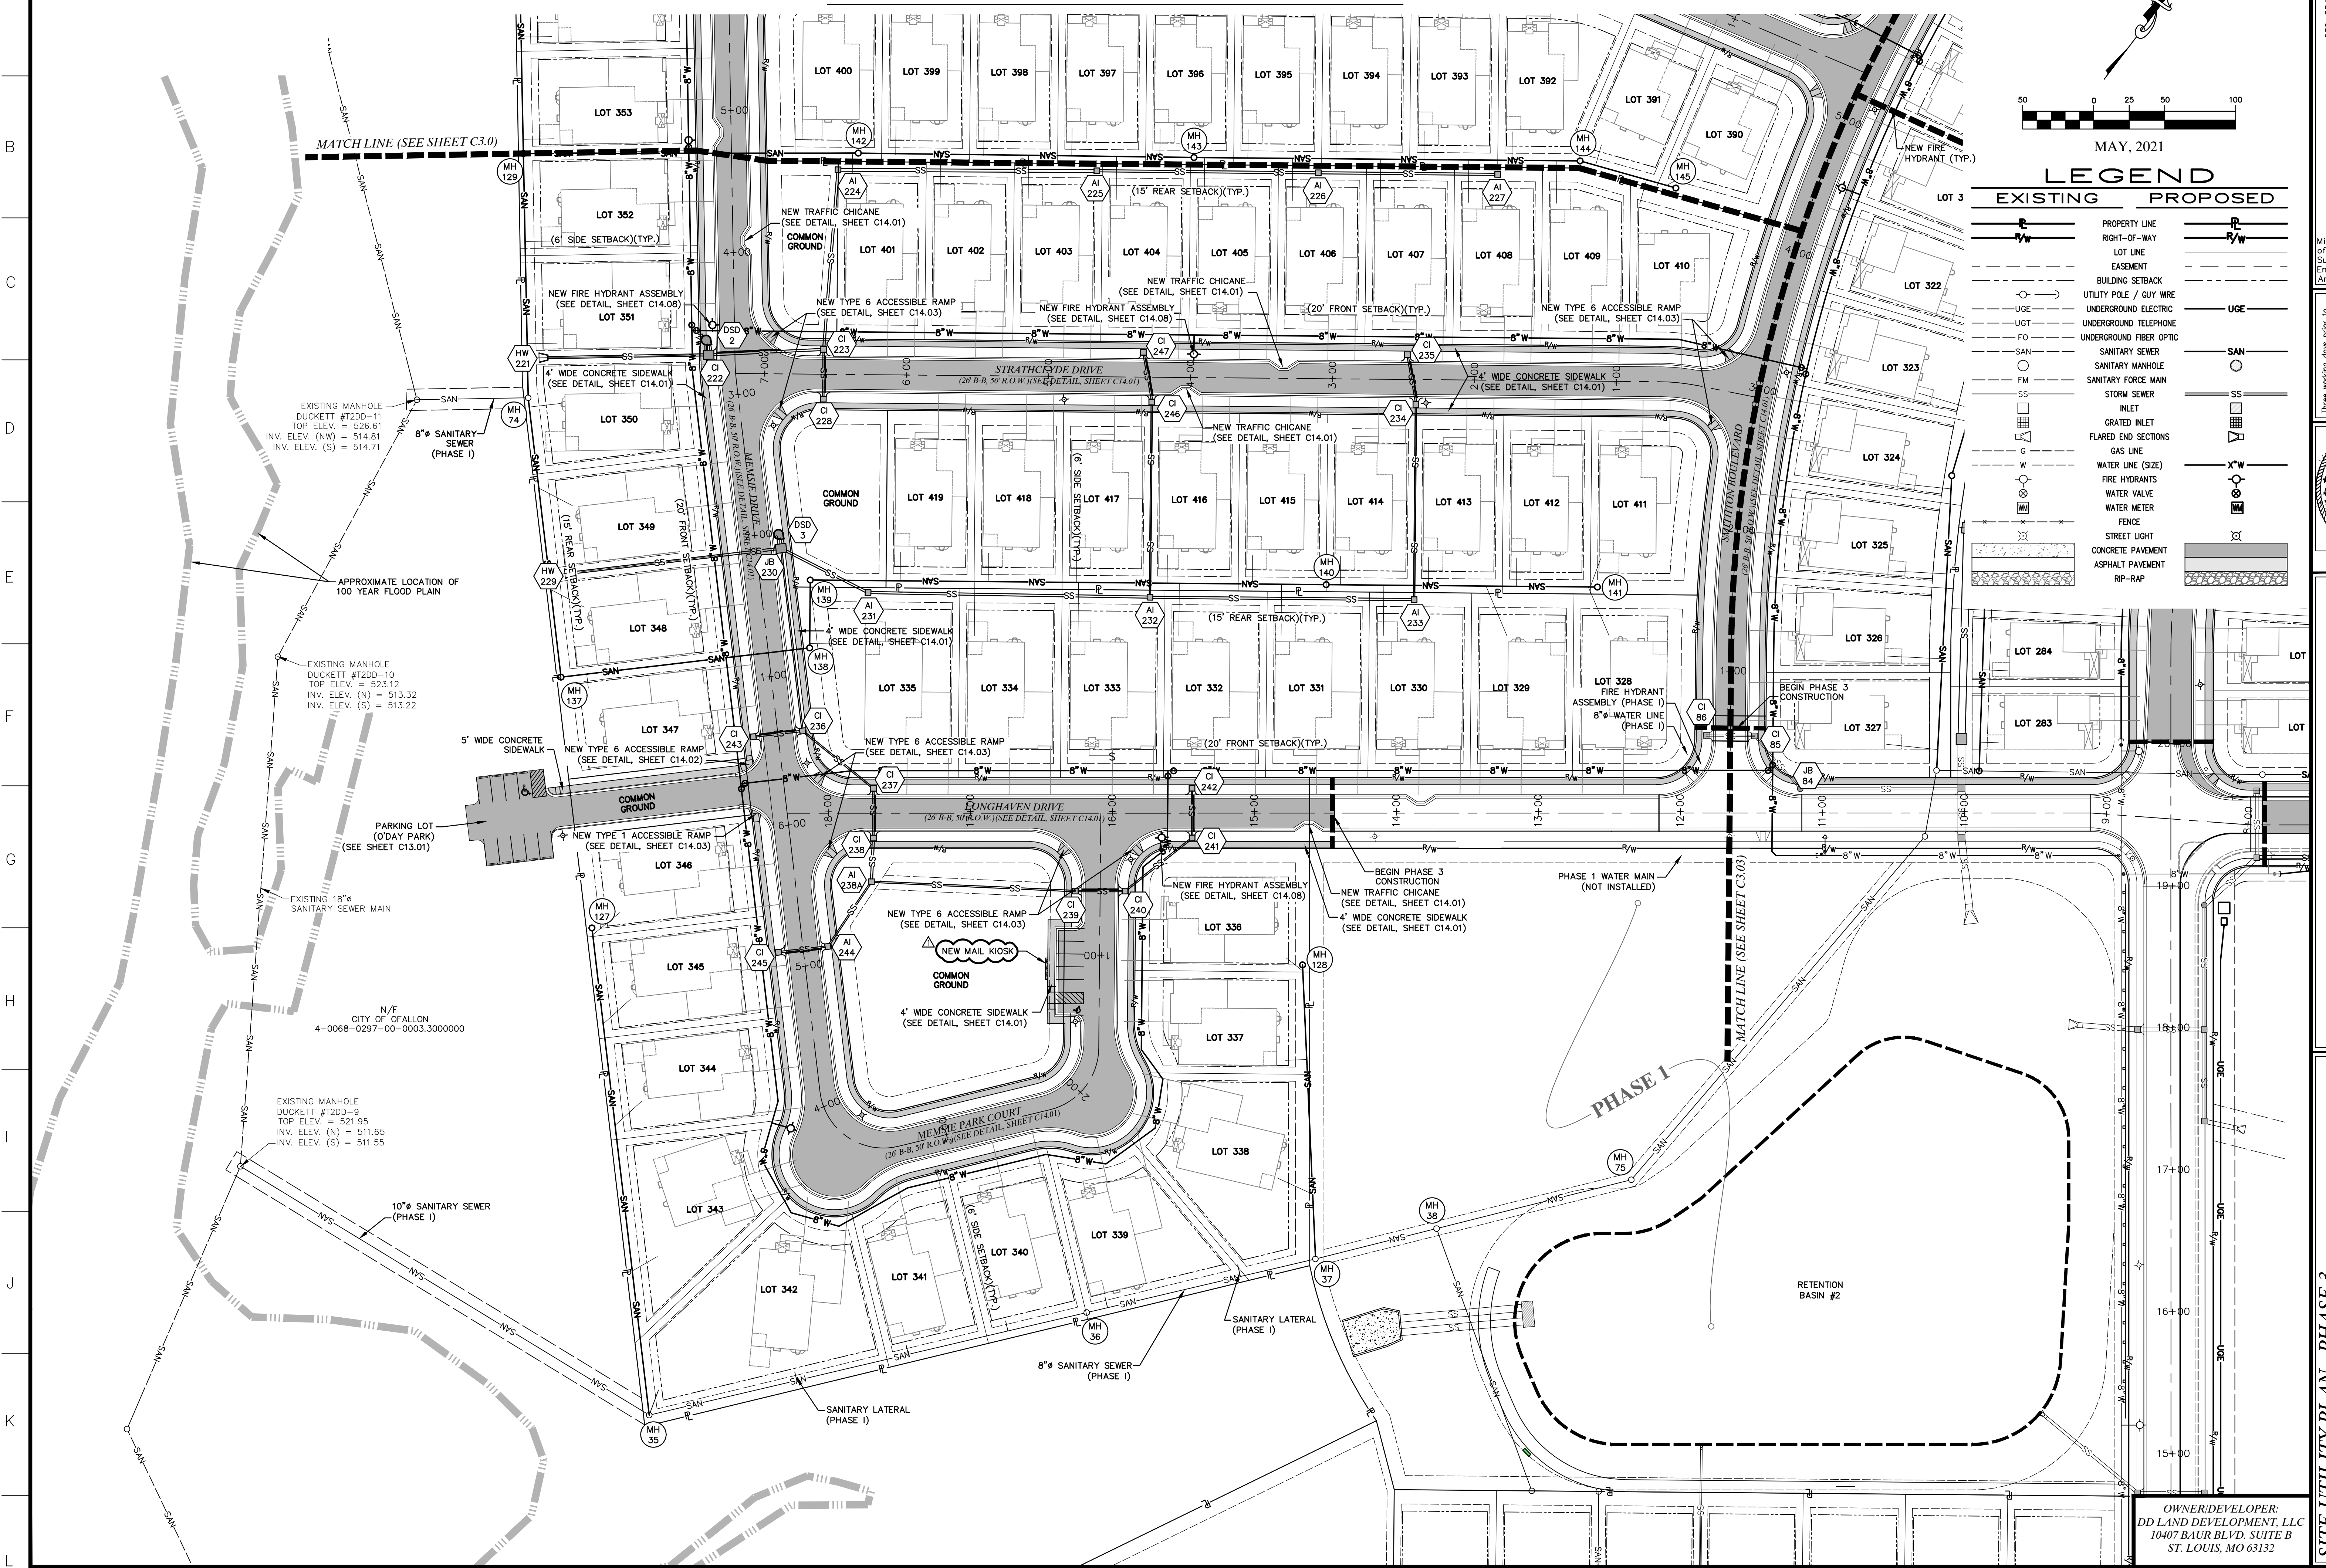

636-594-0540 (tel.)  
636-594-0512 (fax)  
mail@ochran.com  
630A E. Independence Dr.  
Union, Missouri 63084



Missouri State Certificate of Authority Numbers:  
Survey: 000380  
Engineering: 001655  
Architecture: 2002104240

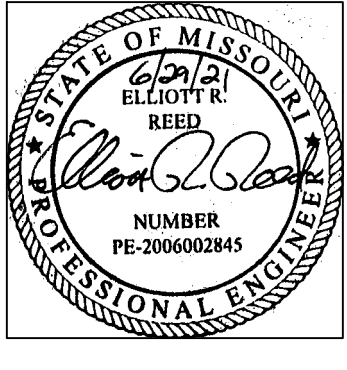

THE STREETS OF CALEDONIA  
 PHASE 3 RESIDENTIAL  
 O'FALLON, MISSOURI

DATE		BY	
DATE	BY	DATE	BY
06-29-21	JMM	06-29-21	JMM
REVIEW COMMENTS			
MAY 25, 2021			
SCALE: 1" = 50'			
PROJECT NO: 17-6821			
DRAWING NO: C3.01			

OWNER/DEVELOPER:  
DD LAND DEVELOPMENT, LLC  
10407 BAUR BLVD, SUITE B  
ST. LOUIS, MO 63132

Drawing name: E:\17-6821 - 860 Acre Tract along Hwy 40, O'Fallon, MO\AutoCad Drawings\6821 - Plan Sheets\Construction Drawings\PH3 Residential Plans\04\_Site Utility Plan Phase 3.dwg Tab: SITE UTILITY PLAN PH3-2 Plotted on: Jun 29, 2021 - 4:04pm Plotted by: tschawo