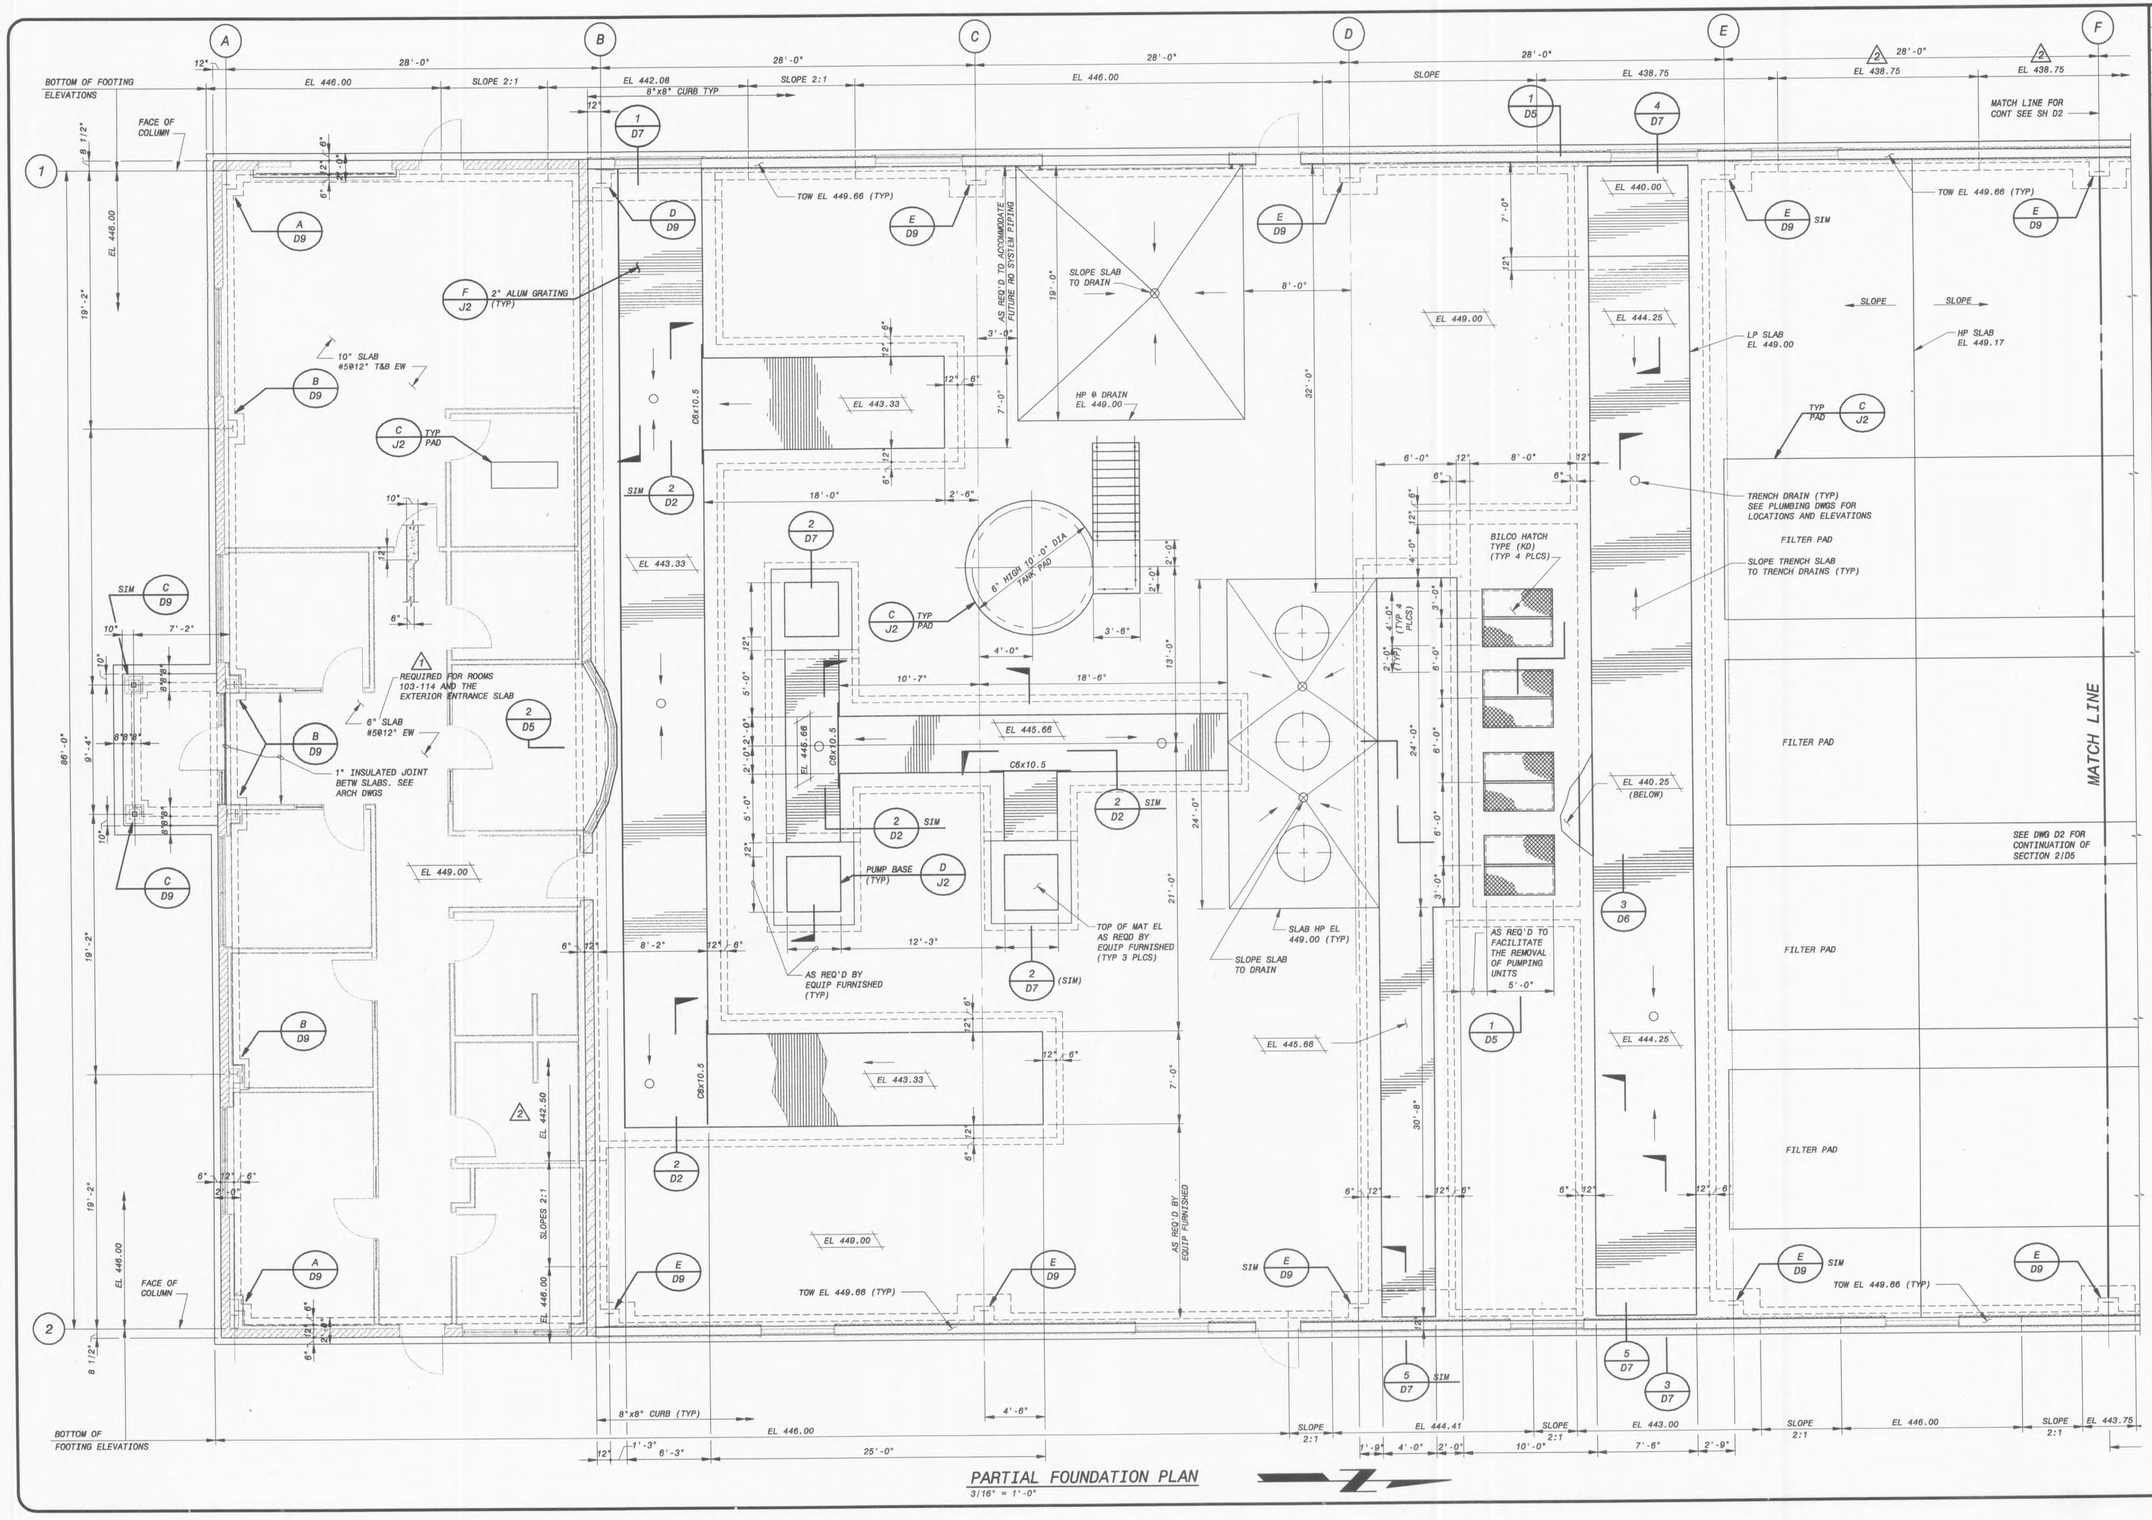

PARTIAL FOUNDATION PLAN
3/16" = 1'-0"

NO.	BY	CK	APP
2			
1			

CONFORMED TO CONSTRUCTION RECORDS
ADDENDUM
REVISIONS AND RECORD OF ISSUE

DATE	
CYGNET ID:	97515-300-S-T00000F7D
SAVED:	IVA44269, 10/12/2004 10:40:12 AM
DWG VER #:	7.5
PLOTTED:	IVA44269, 10/12/2004 9:01:47 AM
USER:	BOW14813
XREF1 ID:	T00000CAJ.dwg
XREF2 ID:	T00000D9M.dwg
XREF3 ID:	T00000F7B.dwg
XREF4 ID:	
XREF5 ID:	

"THIS DRAWING WAS ORIGINALLY APPROVED FOR CONSTRUCTION BY WILLIAM F. RILEY ON 10/08/01 AND SEALED BY WILLIAM F. RILEY A LICENSED PROFESSIONAL ENGINEER IN THE STATE OF MISSOURI, NO. E-20756"

BLACK & VEATCH Corporation
St. Louis, Missouri

CITY OF O'FALLON, MISSOURI
WATER TREATMENT PLANT

OPERATIONS BUILDING
STRUCTURAL
PARTIAL FOUNDATION PLAN

DESIGNED:	SLK
DETAILED:	JAB, DPH, CSA
CHECKED:	JER
APPROVED:	MJP
DATE:	2-13-02

PROJECT NO.
97515

D1

SHEET
20 OF

F097515
D97515