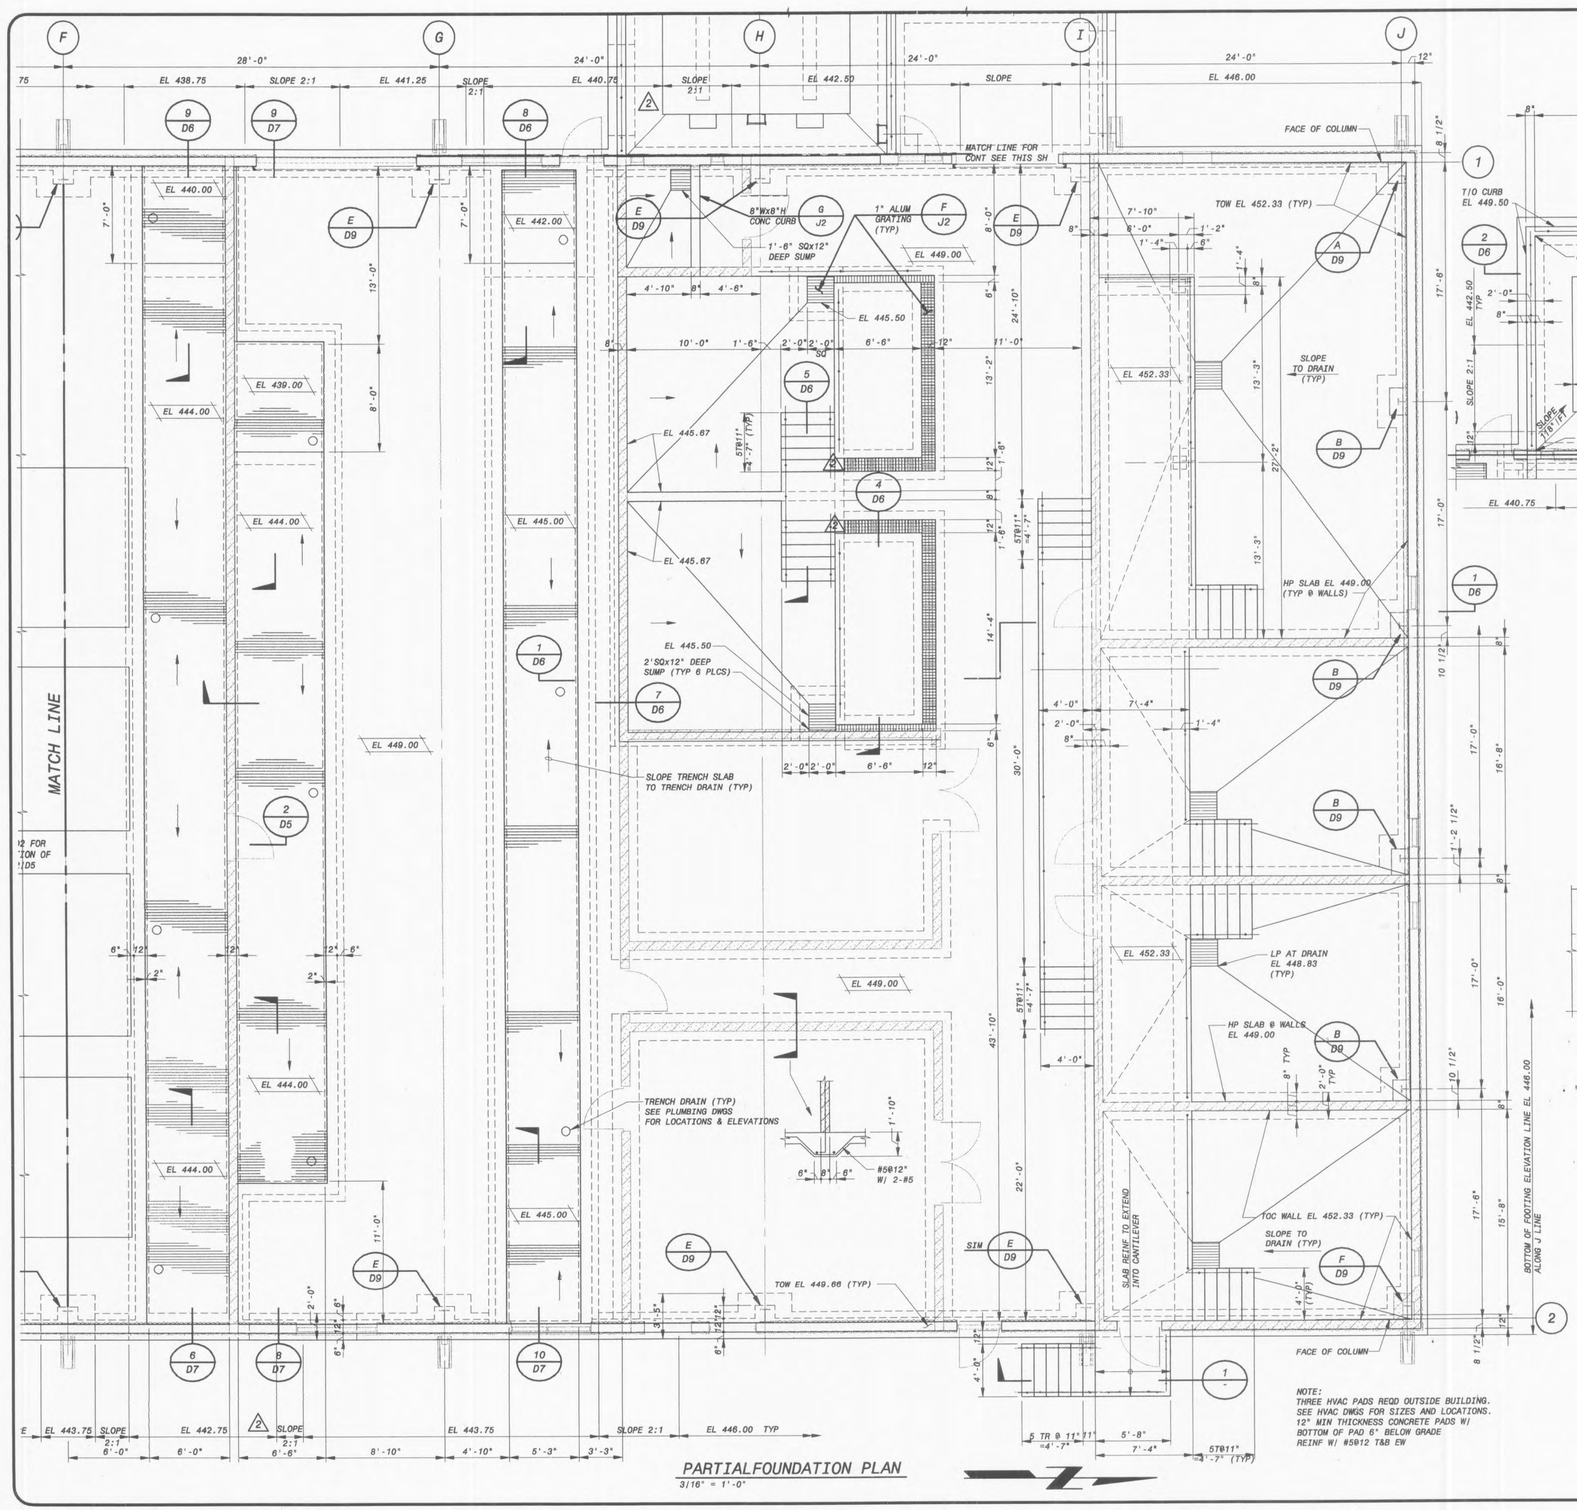

NO.	BY	CK	APP
2			
1			

CONFORMED TO CONSTRUCTION RECORDS
ADDENDUM
REVISIONS AND RECORD OF ISSUE
DATE

CYGNET ID: 97515-300-S-T000000F7E
SAVED: 11/4/2003, 10/22/2004 2:52:35 PM
DWG VER #: 7.3
PLOTTED: 11/4/2003, 10/12/2004 8:59:28 AM
USER: BDW#4813

XREF1 ID: T000000CAJ.dwg
XREF2 ID: T000000DBM.dwg
XREF3 ID: T000000F7B.dwg
XREF4 ID:
XREF5 ID:
SW: ACAD-2000i

"THIS DRAWING WAS ORIGINALLY APPROVED FOR CONSTRUCTION BY WILLIAM F. RILEY ON 10/12/2004 AND SIGNED BY WILLIAM F. RILEY A LICENSED PROFESSIONAL ENGINEER IN THE STATE OF MISSOURI, NO. E-20766"

BLACK & VEATCH Corporation
St. Louis, Missouri

CITY OF O'FALLON, MISSOURI
WATER TREATMENT PLANT

OPERATIONS BUILDING
STRUCTURAL
PARTIAL FOUNDATION PLAN

DESIGNED:	SLK
DETAILED:	JAB, DPH, CSA
CHECKED:	JER
APPROVED:	MJP
DATE:	2-13-02

PROJECT NO.
97515

D2

SHEET 21 OF 96

F097515
D97515