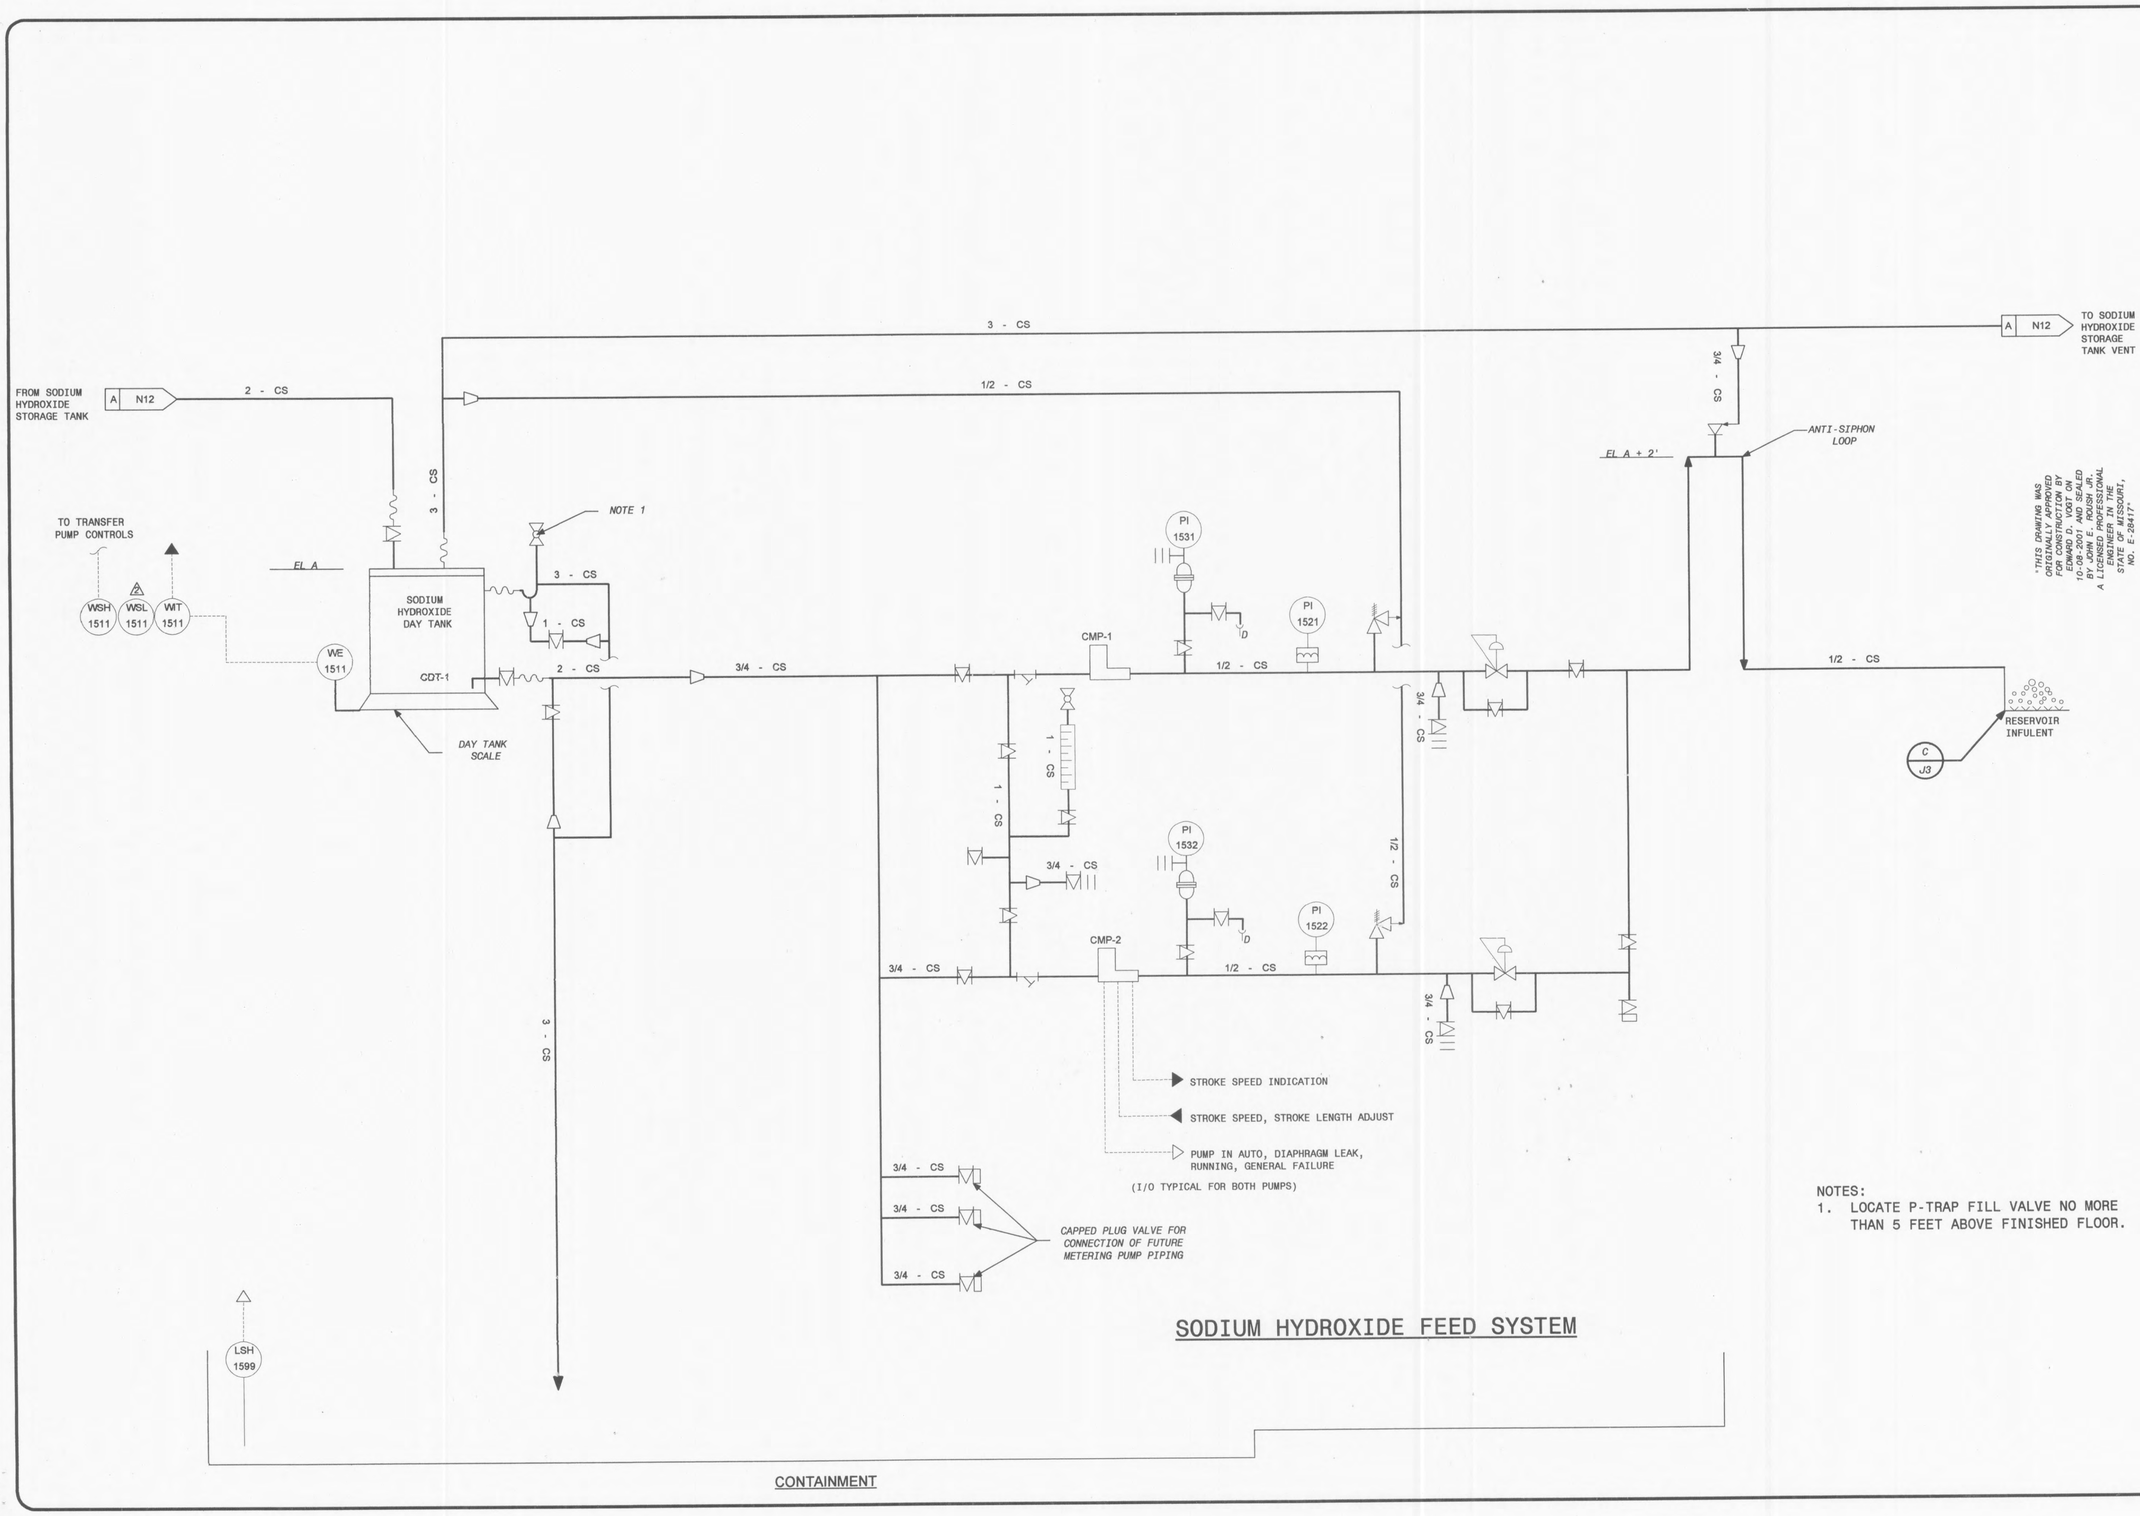

SODIUM HYDROXIDE FEED SYSTEM

NOTES:
1. LOCATE P-TRAP FILL VALVE NO MORE THAN 5 FEET ABOVE FINISHED FLOOR.



NO.	BY	CK.	APP
1			
2			

CONFORMED TO CONSTRUCTION RECORDS
ADDENDUM
REVISIONS AND RECORD OF ISSUE

DATE
CYGNET ID: 97515-300-I-TOOOOOOYL
SAVED:
DWG VER #:
PLOTTED:
USER:

XREF1 ID:
XREF2 ID:
XREF3 ID:
XREF4 ID:
XREF5 ID:
SW: ACTRIX

BLACK & VEATCH Corporation
St. Louis, Missouri

CITY OF O'FALLON, MISSOURI
WATER TREATMENT PLANT

SODIUM HYDROXIDE FEED SYSTEM P&ID

DESIGNED:	SMM
DETAILED:	SMM
CHECKED:	DCG
APPROVED:	EDG
DATE:	10/08/01

PROJECT NO.
97515

N13

SHEET
86 OF 96

97515
D03515