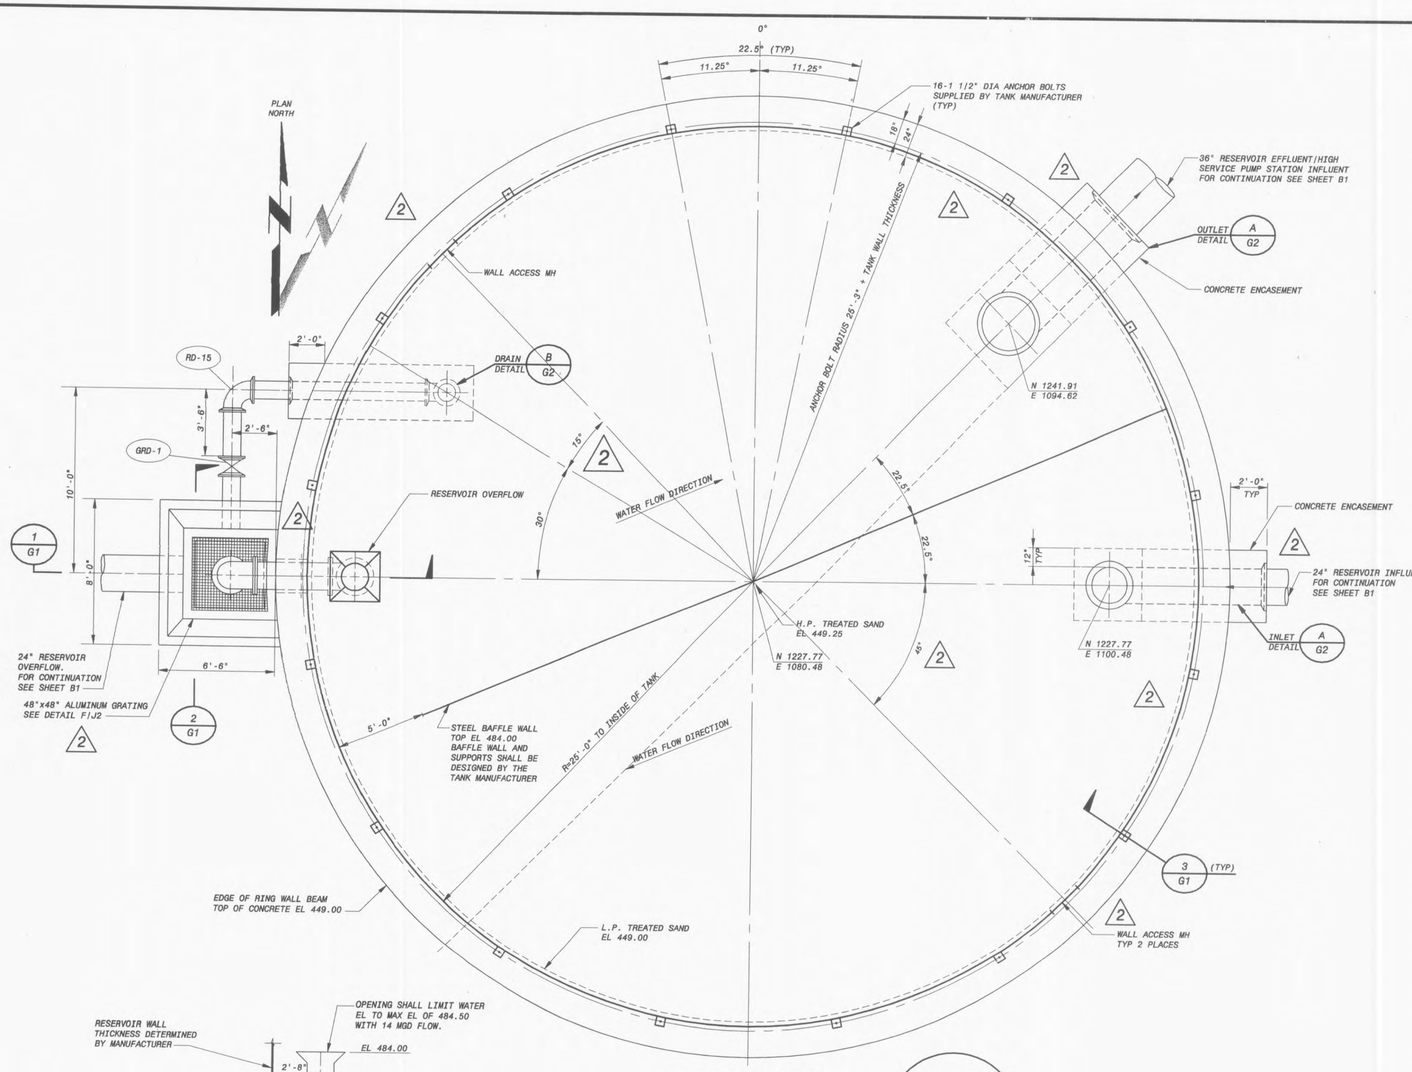

SECTIONAL PLAN
1/4" = 1'-0"

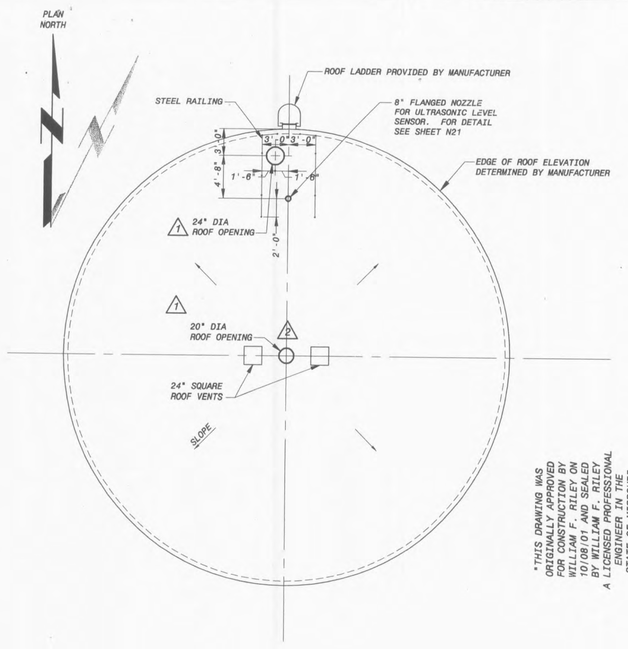

ROOF PLAN
1/8"=1'-0"

THIS DRAWING WAS ORIGINALLY APPROVED FOR CONSTRUCTION BY WILLIAM F. RILEY ON 10/08/01 AND SEALED BY WILLIAM F. RILEY A LICENSED PROFESSIONAL ENGINEER IN THE STATE OF MISSOURI, NO. E-20756

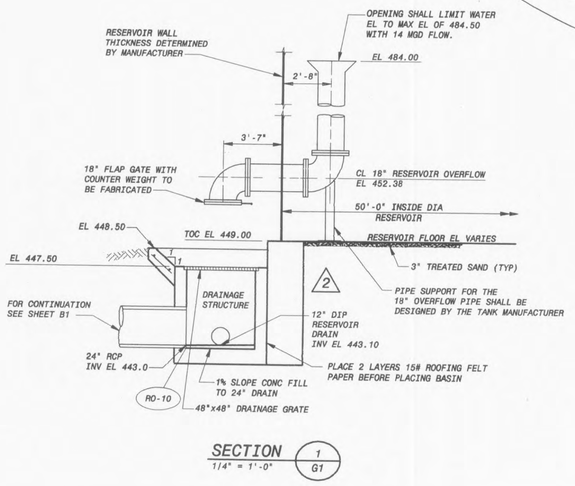

SECTION 1 G1
1/4" = 1'-0"

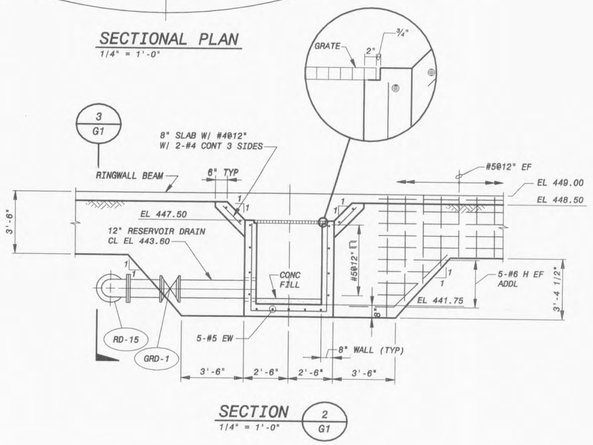

SECTION 2 G1
1/4" = 1'-0"

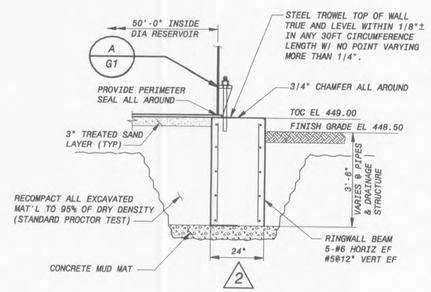

SECTION 3 G1
3/8" = 1'-0"

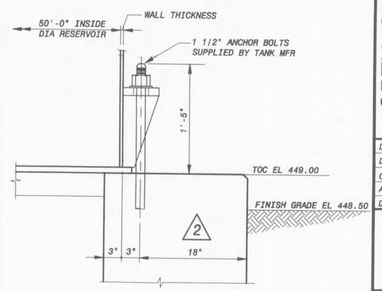

DETAIL A G1
1" = 1'-0"

THIS DRAWING WAS ORIGINALLY APPROVED FOR CONSTRUCTION BY KEVIN M. NELSON ON 10/08/01 AND SEALED BY KEVIN M. NELSON A LICENSED PROFESSIONAL ENGINEER IN THE STATE OF MISSOURI, NO. E-26299

NO.	BY	CK	APP	REVISIONS AND RECORD OF ISSUE
2				CONFORMED TO CONSTRUCTION RECORDS
1				ADDENDUM
				DATE

CYGNET ID: 97515.300.C-T00006827 XREF1 ID:
SAVED: 21444699, 10/25/2004 11:55:18 AM XREF2 ID:
DWG VER #: 7.4 XREF3 ID:
PLOTTED: 21444699, 10/25/2004 11:54:32 AM XREF4 ID:
USER: BKM4813 SW: ACAD-2000i XREF5 ID:

BLACK & VEATCH Corporation
St. Louis, Missouri

CITY OF O'FALLON, MISSOURI
WATER TREATMENT PLANT

TREATED WATER RESERVOIR
SECTIONAL PLAN

DESIGNED:	KMN, BPF, WFR
DETAILED:	DPH, JAB, MAS
CHECKED:	WLK, BLP
APPROVED:	KMN, WFR
DATE:	10/08/01

PROJECT NO.
97515

G1

SHEET 33 OF 96

#97515
D97515